

TO: Adam Lo Bianco PAGE: 1 of 7

DATE: November 06, 2025

PROJECT NO.: 60723990
CONTRACT: Electrical

PROJECT: FMAA QTA

Fort McMurray

REASON FOR ADDENDUM:

Response to RFIs

ISSUED BY: Rick Lin

TO ALL BIDDERS OF RECORD

1. GENERAL

- 1.1 This Addendum is issued prior to Tender closing to provide for certain revisions as noted herein.
- 1.2 All such revisions will become part of the Work and the effects shall be included in the Tender Price
- 1.3 All work shall be performed in accordance with the Contract Documents.

2. REFERENCE DRAWINGS E100

- 2.1 **ADD** separate circuits 2C-13 and 2C-14 to security cabinet on light pole.
- 2.2 **ADD** 120V power provision circuit 2B-10 and 2B-12 with associated new keynote P9 to entry and exit motorized gate.

3. REFERENCE DRAWINGS E201

- 3.1 ADD 2 x 103mm rigid PVC stub up in Comm/IT room for future Telus service connections and new associated keynote T4. **Clarification**: TELUS is undertaking new services to the project area and demarcation point are yet to be determined.
- 3.2 **REVISE** locations of power connection to mechanical equipment P-1, P-2, P-3, P-4, P-5, P-6, B-1, B-2, GFT-3 and BMS in mechanical room.
- 3.3 **REMOVE** power connection to mechanical equipment EF-5 in mechanical room.
- 3.4 **ADD** power provision to mechanical equipment P-7 with circuit 2M-28 and UH-8 with circuit 2M-3.
- 3.5 **ADD** power connection to mechanical equipment SF-2 with circuit 2M-6.
- 3.6 **ADD** 120V connection between thermostat and its controlled mechanical device throughout building area and add new associated keynote P10.
- 3.7 **ADD** power interconnection between VFDs in car wash equipment room and EF-1, EF-2, EF-3, and EF-4. Add associated new keynote P11.

4. REFERENCE DRAWINGS E400

- 4.1 **ADD** 120V 20A breakers for entry and exit gate power in panel 2B.
- 4.2 **REVISE** panel 2C from a 12 circuits panel to a 16 circuits panel.
- 4.3 **ADD** 120V 20A breakers for light pole security cabinet.



DATE:	November 06, 2025	PROJECT NO.:	60723990
PAGE:	2 of 6	CONTRACT:	Electrical


5. REFERENCE DRAWINGS E402

- 5.1 **REVISE** circuit #3 description as show in the clouded area. UH-1, UH-2 and the new added UH-8 to be grouped in the same circuit.
- 5.2 **REVISE** breaker size of 2-poles circuit 13, 17 from 20A to 30A for CU-3.
- 5.3 **REVISE** circuit #6 description and 1 pole breaker size from 20A to 25A for the new added SF-2.
- 5.4 **ADD** 1 pole 20A circuit breaker to circuit #28 for the new added P-7.
- 5.5 **REVISE** mechanical equipment schedule as shown in the clouded area.

6. REFERENCE SPECIFICATION DIV. 26

6.1 **REMOVE** luminaire schedule from 26 50 00 2.4. Replace with description "1. Refer to luminaire schedule on electrical drawing for specification.".

End of Addendum E01

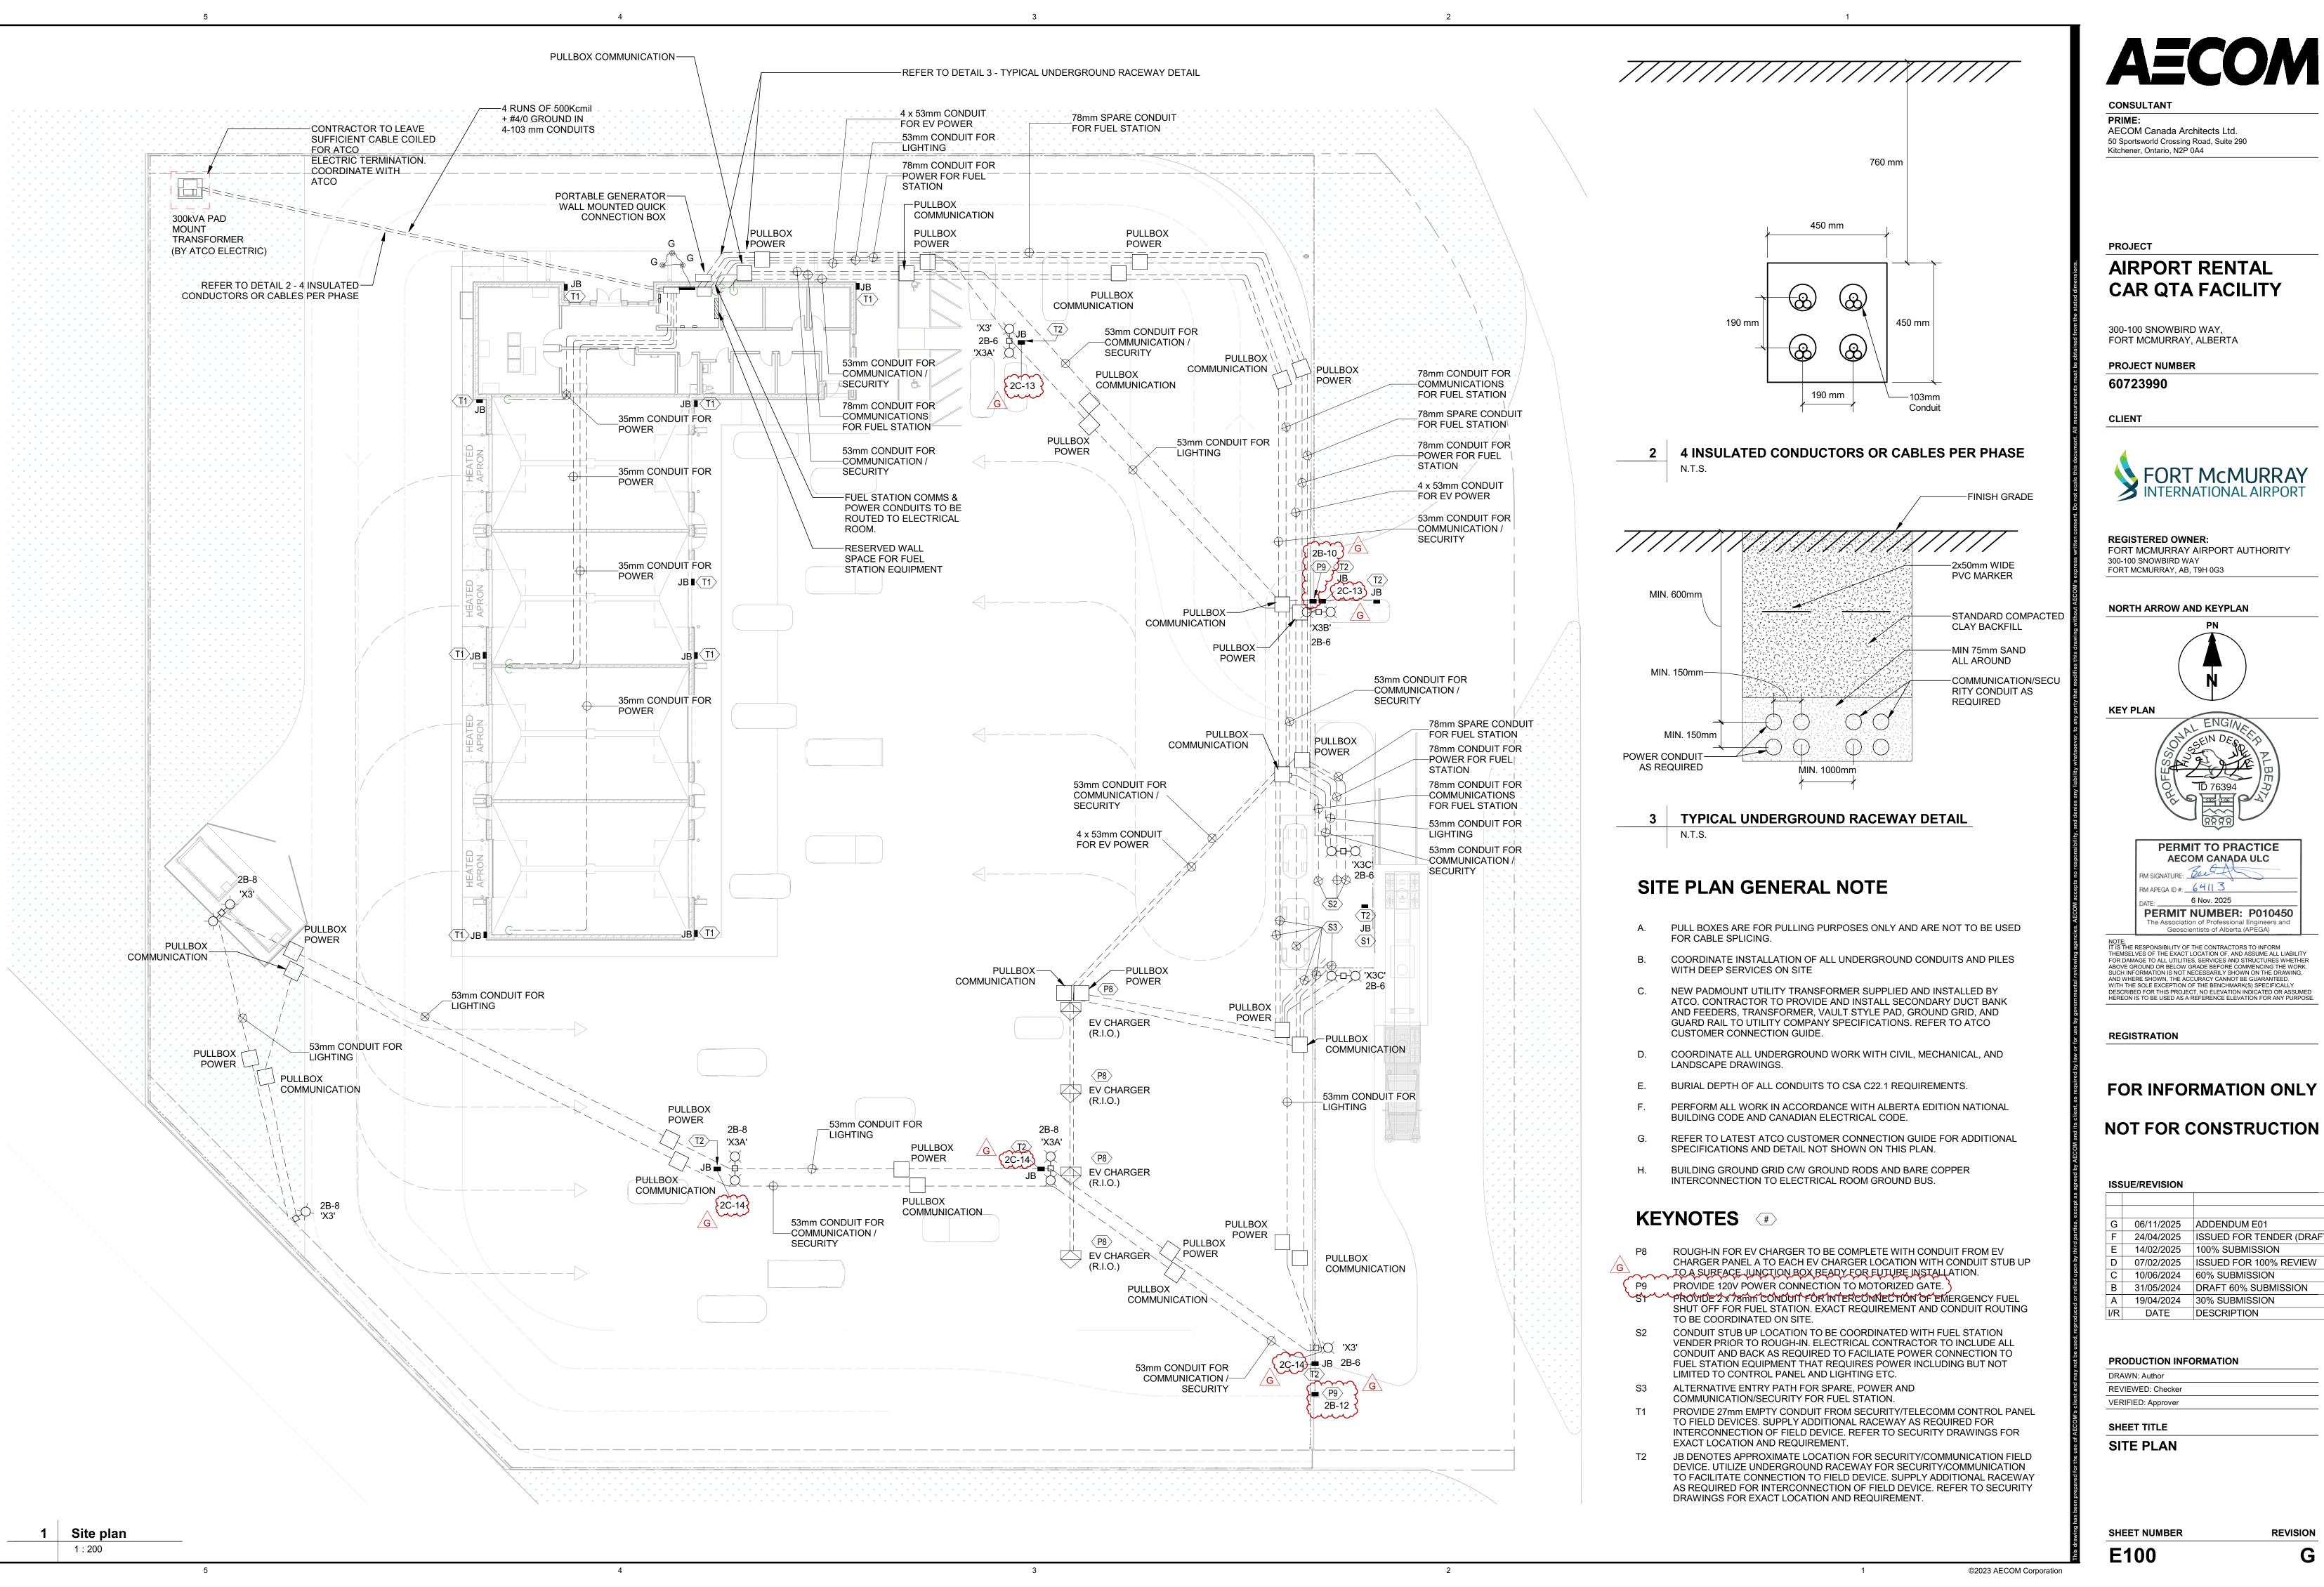

CONSULTANT

AECOM Canada Architects Ltd. 50 Sportsworld Crossing Road, Suite 290

PROJECT

AIRPORT RENTAL CAR QTA FACILITY

300-100 SNOWBIRD WAY, FORT MCMURRAY, ALBERTA

PROJECT NUMBER


60723990

CLIENT




REGISTERED OWNER: FORT MCMURRAY AIRPORT AUTHORITY 300-100 SNOWBIRD WAY FORT MCMURRAY, AB, T9H 0G3

NORTH ARROW AND KEYPLAN

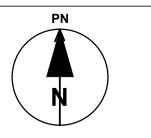

KEY PLAN

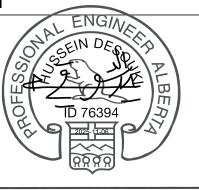

PERMIT TO PRACTICE **AECOM CANADA ULC** RM SIGNATURE: RM APEGA ID #: 64113 6 Nov. 2025 PERMIT NUMBER: P010450

NOTE:
IT IS THE RESPONSIBILITY OF THE CONTRACTORS TO INFORM
THEMSELVES OF THE EXACT LOCATION OF, AND ASSUME ALL LIABILITY
FOR DAMAGE TO ALL UTILITIES, SERVICES AND STRUCTURES WHETHER
ABOVE GROUND OR BELOW GRADE BEFORE COMMENCING THE WORK.
SUCH INFORMATION IS NOT NECESSARILY SHOWN ON THE DRAWING,
AND WHERE SHOWN, THE ACCURACY CANNOT BE GUARANTEED.
WITH THE SOLE EXCEPTION OF THE BENCHMARK(S) SPECIFICALLY
DESCRIBED FOR THIS PROJECT, NO ELEVATION INDICATED OR ASSUMED
HEREON IS TO BE USED AS A REFERENCE ELEVATION FOR ANY PURPOSE.

REGISTRATION

FOR INFORMATION ONLY

ISSUE/REVISION

G	06/11/2025	ADDENDUM E01
F	24/04/2025	ISSUED FOR TENDER (DRAFT)
Е	14/02/2025	100% SUBMISSION
D	07/02/2025	ISSUED FOR 100% REVIEW
С	10/06/2024	60% SUBMISSION
В	31/05/2024	DRAFT 60% SUBMISSION
Α	19/04/2024	30% SUBMISSION
I/R	DATE	DESCRIPTION

PRODUCTION INFORMATION


DRAWN: Author REVIEWED: Checker VERIFIED: Approver

SHEET TITLE

SITE PLAN

SHEET NUMBER E100

REVISION

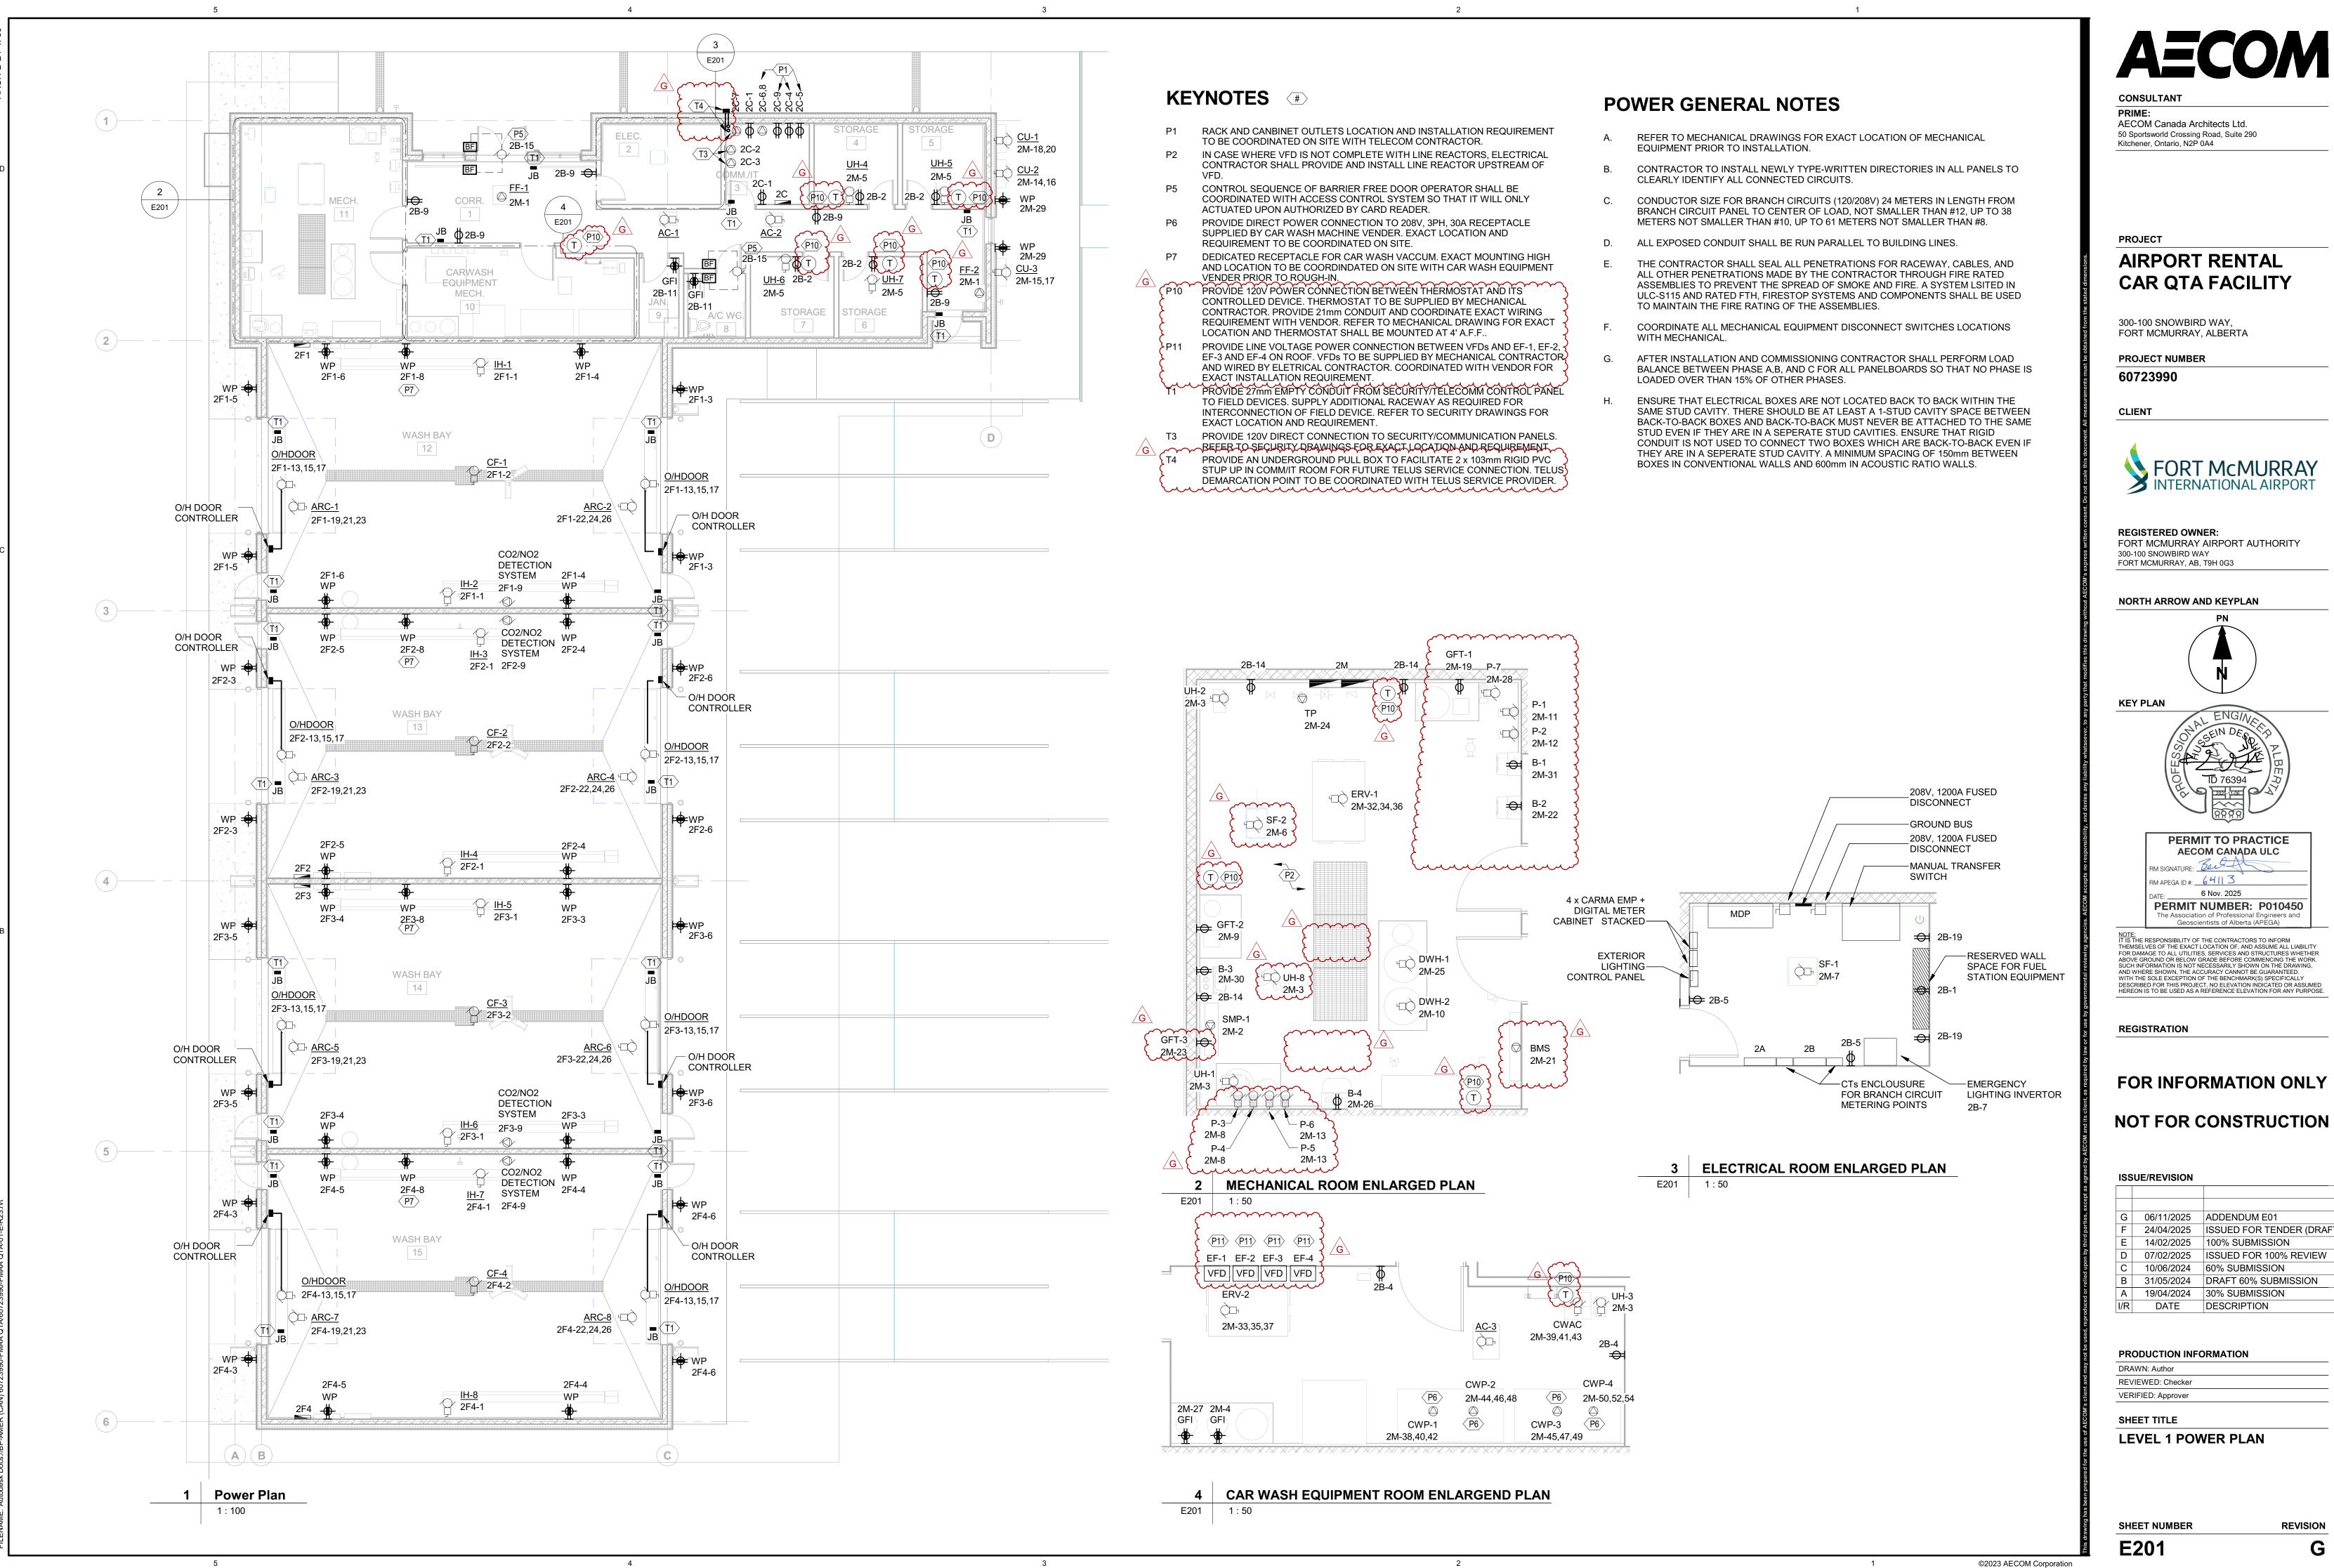

AECOM

CONSULTANT

AECOM Canada Architects Ltd. 50 Sportsworld Crossing Road, Suite 290 Kitchener, Ontario, N2P 0A4

PROJECT

AIRPORT RENTAL CAR QTA FACILITY

300-100 SNOWBIRD WAY, FORT MCMURRAY, ALBERTA

PROJECT NUMBER


60723990

CLIENT

S FORT McMURRAY

REGISTERED OWNER: FORT MCMURRAY AIRPORT AUTHORITY 300-100 SNOWBIRD WAY FORT MCMURRAY, AB, T9H 0G3

NORTH ARROW AND KEYPLAN

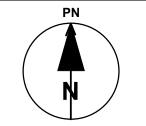

KEY PLAN



PERMIT TO PRACTICE AECOM CANADA ULC RM SIGNATURE: Belg-All RM APEGA ID #: 64113 6 Nov. 2025 PERMIT NUMBER: P010450

NOTE: IT IS THE RESPONSIBILITY OF THE CONTRACTORS TO INFORM THEMSELVES OF THE EXACT LOCATION OF, AND ASSUME ALL LIABILITY FOR DAMAGE TO ALL UTILITIES, SERVICES AND STRUCTURES WHETHER FOR DAMAGE TO ALL UTILITIES, SERVICES AND STRUCTURES WHETHER ABOVE GROUND OR BELOW GRADE BEFORE COMMENCING THE WORK. SUCH INFORMATION IS NOT NECESSARILY SHOWN ON THE DRAWING, AND WHERE SHOWN, THE ACCURACY CANNOT BE GUARANTEED. WITH THE SOLE EXCEPTION OF THE BENCHMARK(S) SPECIFICALLY DESCRIBED FOR THIS PROJECT, NO ELEVATION INDICATED OR ASSUMED HEREON IS TO BE USED AS A REFERENCE ELEVATION FOR ANY PURPOSE.

REGISTRATION

FOR INFORMATION ONLY

ISSUE/REVISION

G	06/11/2025	ADDENDUM E01
F	24/04/2025	ISSUED FOR TENDER (DRAFT
Е	14/02/2025	100% SUBMISSION
D	07/02/2025	ISSUED FOR 100% REVIEW
С	10/06/2024	60% SUBMISSION
В	31/05/2024	DRAFT 60% SUBMISSION
Α	19/04/2024	30% SUBMISSION
I/R	DATE	DESCRIPTION

PRODUCTION INFORMATION

DRAWN: Author

REVIEWED: Checker VERIFIED: Approver

SHEET TITLE

LEVEL 1 POWER PLAN

SHEET NUMBER **REVISION**

CKT

1,2,3

4,5,6

7,8,9

Legend:

HVAC

Other

LIGHTING

10,11,12 2M

13,14,15 2F1

16,17,18 2F2

19,20,21 2F3

22,23,24 2F4

Load Classification

CABINET OUTLET

CONV. RECEPT.

RACK OUTLET

DOOR OPERATOR

COMMUNICATION

25,26,27 SPACE

28,29,30 SPACE

Location: ELEC 08

Circuit Description

Connected Load

126016 VA

6993 VA

4400 VA

5760 VA

13800 VA

7312 VA

4992 VA

1800 VA

Supply From:

Mounting:

Enclosure:

Volts: 208/120 Wye
Phases: 3
Wires: 4

Trip

200 A

100 A

50 A

200 A

70 A

70 A

70 A

70 A

Estimated Demand

94512 VA

8741 VA

4400 VA

2880 VA

8280 VA 4387 VA

3744 VA

1800 VA

A.I.C. Rating: 35kA

Mains Type: LGIS

Mains Rating: 1200 A

0 VA

6357 VA

5296 VA

22122 VA

6512 VA

6512 VA

6512 VA

6512 VA

59825 VA

499 A

Panel Totals

Total Conn. Load: 171073 VA

Total Est. Demand: 128745 VA

Total Conn. Current: 475 A

Total Est. Demand Current: 357 A

Total Est. Demand Current *1.25: 447 A

Total Est. Demand Current * 1.25: 44 A

Total Load:

Total Amps:

0 VA

3686 VA

4440 VA

21744 VA

6362 VA

6362 VA

6362 VA

6362 VA

55319 VA

461 A

Branch Panel: 2A

Location: ELEC 08
Supply From: MDP
Mounting: Surface
Enclosure: Type 1

Volts: 208/120 Wye
Phases: 3
Wires: 4

A.I.C. Rating: 12kA Mains Type: MLO Mains Rating: 225 A

Notes

С

0 VA

3750 VA

4416 VA

22315 VA

6362 VA

6362 VA


6362 VA

6362 VA

--

55930 VA

467 A

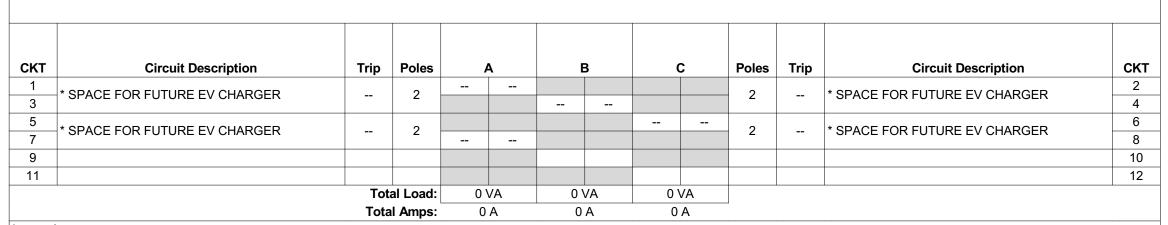

Legend:

* - BRANCH CIRCUIT TO BE PROVIDED WITH SEPARATE DIG

* - BRANCH CIRCUIT TO BE PROVIDED WITH SEPARATE DIGITAL METERING									
Load Classification	Connected Load	Demand Factor	Estimated Demand	Panel To	tals				
				Total Conn. Load:	0 VA				
				Total Est. Demand:	0 VA				
				Total Conn. Current:	0 A				
				Total Est. Demand Current:	0 A				
				Total Est. Demand Current * 1.25:	0 A				

Branch Panel: 2B Location: ELEC 08 A.I.C. Rating: 12kA Volts: 208/120 Wye Supply From: MDP Phases: 3 Mains Type: MLO Mounting: Surface Wires: 4 Mains Rating: 100 A Enclosure: Type 1 CKT Poles Trip **Circuit Description** Trip Poles С **Circuit Description** 1 20 A CONV. RECEPT. STORAGE 4, 5 286 400 1 20 A CONV. RECEPT. COMM./IT 16 1 CONV. RECEPT. ELEC 08 20 A 1 200 800 1 20 A CONV. RECEPT. STORAGE 4, 5, 6, 7 3 * BUILDING EXTERIOR LIGHTING 400 | 1350 | 1 | 20 A | * EXTERIOR LIGHTING 5 CONV. RECEPT. 7 * EMERGENCY LIGHTING INVERTOR 20 A 1 1026 1050 1 20 A ENTRY GATE POWER 9 CONV. RECEPT. ELEC 08 1000 1600 20 A 1 11 WC. 06 1 20 A CONV. RECEPT. MECH 09 13 * BUILDING LIGHTING 20 A 1 1 1081 1800 20 A 1 15 DOOR OPERATOR 400 19 CONV. RECEPT. ELEC 08 20 A 1 400 21 22 23 24 27 SPARE 1 20 A SPARE 28 29 SPARE 20 A 1 0 0 1 20 A SPARE 30 3686 VA Total Load: 6357 VA 3750 VA Total Amps: 53 A 31 A 31 A * - BRANCH CIRCUIT TO BE PROVIDED WITH SEPARATE DIGITAL METERING Load Classification **Demand Factor Estimated Demand** Panel Totals Connected Load LIGHTING 4793 VA 125.00% 5991 VA 3200 VA 100.00% 3200 VA Total Conn. Load: 13793 VA CONV. RECEPT. Total Est. Demand: 12671 VA 5400 VA 60.00% 3240 VA DOOR OPERATOR 400 VA 60.00% 240 VA Total Conn. Current: 38 A **Total Est. Demand Current:** 35 A

Demand Factor

75.00%

125.00%

100.00%

50.00%

60.00%

60.00%

75.00%

100.00%

Branch Panel: 2C Location: COMM./IT 3 Supply From: MDP Mounting: Surface					ı	Volts: Phases: Wires:) Wye		A.I.C. Rating: 12kA Mains Type: MLO Mains Rating: 50 A				
Notes:	Enclosure: Type 1													
СКТ	Circuit Decembring	Tuite	Dalas		•		n		•	Dalas	Tuis	Cincuit Page		СКТ
1	Circuit Description CONV. RECEPT. COMM./IT 3	Trip 20 A	Poles 1	400	A 600		B 		C 	Poles 1	Trip 20 A	•		2
3	RACK OUTLET	20 A	1	400	000	600	1920			1		ACCESS CONTROL SYSTE		4
5	CABINET RECEPT. COMM./IT 3	20 A	1					1920	2496	_				6
7	ISP CABINET	20 A	1	600	2496					2	20 A	RACK OUTLET		8
9	CABINET RECEPT. COMM./IT 3	20 A	1			1920								10
~44~		~~~	~~~	~~	~~~	~~	~~~	~~~	~~~	~~~	~~~	~~~~~~	~~~~	12~
13	LIGHT POLE SECURITY CABINET	20 A	1	480	720					1	20 A	LIGHT POLE SECURITY CA	ABINET	14
15	SPARE	20 A	1			0	0			1	20 A	SPARE		16
			al Load:		6VA		OVA		64A~					
		Tota	I Amps:	44	ł A	37	7 A	37	7 A					
_egen * - BR/	d: ANCH CIRCUIT TO BE PROVIDED WITH SEPARAT	E DIGIT	AL METE	RING										
_oad (Classification		nected I			nand Fa		Estin	nated De			Panel To	tals	
Other			1200 VA			100.00%			1200 VA					
CABIN	IET OUTLET		5760 VA			50.00%			2880 VA	Ī		Total Conn. Load:		
	. RECEPT.		400 VA			60.00%			240 VA			Total Est. Demand:		
		4992 VA 75.00% 3744 VA			Total Conn. Current: 39 A		39 A							
RACK	OUTLET							1800 VA						
RACK	OUTLET IUNICATION		1800 VA			100.00%	, D		1800 VA	L		Total Est. Demand Current: Est. Demand Current * 1.25:		

PANEL SCHEDULE GENERAL NOTES

- A. CONTRACTOR TO INSTALL NEWLY TYPE-WRITTEN DIRECTORIES IN ALL PANELS TO CLEARLY IDENTIFY ALL CONNECTED CIRCUITS.
 - AFTER INSTALLATION AND COMMISSIONING CONTRACTOR SHALL PERFORM LOAD BALANCE BETWEEN PHASE A,B, AND C FOR ALL PANELBOARDS SO THAT NO PHASE IS LOADED OVER THAN 15% OF OTHER PHASES.

AECOM

CONSULTANT PRIME:

PRIME:
AECOM Canada Architects Ltd.
50 Sportsworld Crossing Road, Suite 290
Kitchener, Ontario, N2P 0A4

PROJECT

AIRPORT RENTAL CAR QTA FACILITY

300-100 SNOWBIRD WAY, FORT MCMURRAY, ALBERTA

PROJECT NUMBER


60723990

CLIENT



REGISTERED OWNER:
FORT MCMURRAY AIRPORT AUTHORITY
300-100 SNOWBIRD WAY
FORT MCMURRAY, AB, T9H 0G3

NORTH ARROW AND KEYPLAN

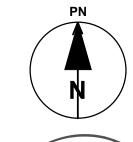

KEY PLAN



PERMIT TO PRACTICE AECOM CANADA ULC
RM SIGNATURE: 6 H 1 3
DATE: 6 Nov. 2025
PERMIT NUMBER: P010450

NOTE:
IT IS THE RESPONSIBILITY OF THE CONTRACTORS TO INFORM
THEMSELVES OF THE EXACT LOCATION OF, AND ASSUME ALL LIABILITY
FOR DAMAGE TO ALL UTILITIES, SERVICES AND STRUCTURES WHETHER
ABOVE GROUND OR BELOW GRADE BEFORE COMMENCING THE WORK.
SUCH INFORMATION IS NOT NECESSARILY SHOWN ON THE DRAWING,
AND WHERE SHOWN, THE ACCURACY CANNOT BE GUARANTEED.
WITH THE SOLE EXCEPTION OF THE BENCHMARK(S) SPECIFICALLY
DESCRIBED FOR THIS PROJECT, NO ELEVATION INDICATED OR ASSUMED
HEREON IS TO BE USED AS A REFERENCE ELEVATION FOR ANY PURPOSE.

REGISTRATION

FOR INFORMATION ONLY NOT FOR CONSTRUCTION

ISSUE/REVISION

G	06/11/2025	ADDENDUM E01
F	24/04/2025	ISSUED FOR TENDER (DRAFT
Ε	14/02/2025	100% SUBMISSION
D	07/02/2025	ISSUED FOR 100% REVIEW
С	10/06/2024	60% SUBMISSION
В	31/05/2024	DRAFT 60% SUBMISSION
Α	19/04/2024	30% SUBMISSION
I/R	DATE	DESCRIPTION

PRODUCTION INFORMATION

DRAWN: Author
REVIEWED: Checker

VERIFIED: Approver

SHEET TITLE

ELECTRICAL SCHEDULES

SHEET NUMBER

E400

REVISION

Location: MECH. 11 Supply From: MDP Mounting: Surface Enclosure: Type 1

Volts: 208/120 Wye

A.I.C. Rating: Mains Type: MLO Mains Rating: 225 A

СКТ	Circuit Description	Trip	Poles		A	ı	В		C	Poles	Trip	Circuit Description	СКТ
1	FE-1& FE-2	20 A	1	60	197					1	20 A	SNOW MELT PANEL SMP-1	2
3	UH-1 & UH-2 & UH-8	20 A	113			173	200			\sim 1 \sim	20 A	WATER SOFTNER CARWASH EQUIP, MECH. 10	
5	UH-4, UH-5, UH-6 & UH-7	20 A	1					148	217	1	25 A		6
7	SF-1	20 A	1	370	394					1	20 A	P-3 & P-4	8
9	GFT-2	20 A	1			50	600			1	20 A	DWH-2	10
11	P-1	20 A	1					480	480	1	20 A	P-2	12
13	P-5 & P-6	~20A~	1	394	1581					2	20 A	CU-2	14
15	CU-3	30 A	2			2163	1581				20 A	00-2	16
17	(}					2163	2080	2	30 A	CU-1	18
19	GFT-1	20 A	1	50	2080						30 A	00-1	20
21	BUILDING MANAGEMENT SYSTEM	20 A	1			200	300			1	20 A	B-2	22
23	GFT-3	20 A	1					50	200	1	20 A	TRAP PRIMER	24
25	DWH-1	20 A	1	600	300					1	20 A	B-4	26
27	WATER SOFTNER CARWASH EQUIP. MECH. 10	20 A	1			200	480		(أسأسأ	20 A	P-Žunanananananan	28
29	CONV. RECEPT. EXTERIOR	20 A	1					400	300	1	20 A	B-3	30
31	B-1	20 A	1	300	701								32
33						701	701			3	20 A	ERV-1	34
35	ERV-2	20 A	3					701	701				36
37				701	2879							* OADWAGU EQUIDMENT TAUGT LOOK	38
39						2879	2879			3	30 A	* CARWASH EQUIPMENT TWIST LOCK RECEPT.	40
41	* WASH BAY VACCUM	20 A	3					2879	2879			INCOLI I.	42
43	-			2879	2879							* OADWARD FOUNDMENT TAKET LOOK	44
45	* 0.4 D.W.4 O.L. E.O. U.D. 4 E.N.T. T.M.O.T. L. O.M.4					2879	2879			3	20 A	* CARWASH EQUIPMENT TWIST LOCK RECEPT.	46
47	* CARWASH EQUIPMENT TWIST LOCK RECEPT.	30 A	3					2879	2879			INCOLI I.	48
49	- NEGEL 1.			2879	2879							* CARWARU FOURNIENT TAWOT LOOK	50
51							2879			3	20 A	* CARWASH EQUIPMENT TWIST LOCK RECEPT.	52
53									2879			INCOLI I.	54
55													56
57													58
59													60
61													62
63													64
65													66
67													68
69													70
71													72
73													74
75													76
77													78
79													80
81	SPARE	20 A	1			0	0			1	20 A	SPARE	82
83	SPARE	20 A	1					0	0	1		SPARE	84
	1		al Load:	2212	22 VA	2174	4 VA	2231	5 VA		1	1	
		Tota	l Amps:	18	5 A	18	1 A	18	6 A				

* - BRANCH CIRCUIT TO BE PROVIDED WITH SEPARATE DIGITAL METERING

Connected Load	Demand Factor	Estimated Demand	Panel To	tals
66180 VA	75.00%	49635 VA		
			Total Conn. Load:	66180 VA
			Total Est. Demand:	49635 VA
			Total Conn. Current:	184 A
			Total Est. Demand Current:	138 A
			Total Est. Demand Current * 1.25:	172 A
		20	20111101101 2011111111	

PANEL SCHEDULE GENERAL NOTES

- A. CONTRACTOR TO INSTALL NEWLY TYPE-WRITTEN DIRECTORIES IN ALL PANELS TO
- CLEARLY IDENTIFY ALL CONNECTED CIRCUITS.
- AFTER INSTALLATION AND COMMISSIONING CONTRACTOR SHALL PERFORM LOAD BALANCE BETWEEN PHASE A,B, AND C FOR ALL PANELBOARDS SO THAT NO PHASE IS LOADED OVER THAN 15% OF OTHER PHASES.

					JIPMEN ⁻			
AG	DESCRIPTION INDOOR AIR CONDITIONING LINIT	VOLTAGE			CONDUCTOR		STARTER	NOTE
AC-1	INDOOR AIR CONDITIONING UNIT	208 V	2	0 VA	2#12+#12BND	21mmC	SPPC	POWER BY OUTDOOR UNIT
\C-2	INDOOR AIR CONDITIONING UNIT	208 V	2	0 VA	2#12+#12BND	21mmC	SPPC	POWER BY OUTDOOR UNIT
AC-3	INDOOR AIR CONDITIONING UNIT	208 V	3	0 VA	2#12+#12BND	21mmC	SPPC SPPC	POWER BY OUTDOOR UNIT
ARC-1 ARC-2	AIR CURTAIN AIR CURTAIN	208 V 208 V	3	4480 VA 4480 VA	3#12+#12BND 3#12+#12BND	21mmC 21mmC	SPPC	
ARC-2 ARC-3	AIR CURTAIN AIR CURTAIN	208 V	3	4480 VA	3#12+#12BND	21mmC	SPPC	
ARC-4	AIR CURTAIN	208 V	3	4480 VA	3#12+#12BND	21mmC	SPPC	
ARC-5	AIR CURTAIN	208 V	3	4480 VA	3#12+#12BND	21mmC	SPPC	
ARC-6	AIR CURTAIN	208 V	3	4480 VA	3#12+#12BND	21mmC	SPPC	
ARC-7	AIR CURTAIN	208 V	3	4480 VA	3#12+#12BND	21mmC	SPPC	
ARC-8	AIR CURTAIN	208 V	3	4480 VA	3#12+#12BND	21mmC	SPPC	
B-1	GAS HOT WATER BOILER	120 V	1	300 VA	2#12+#12BND	21mmC	SPPC	
B-2	GAS HOT WATER BOILER	120 V	1	300 VA	2#12+#12BND	21mmC	SPPC	
B-3	GAS HOT WATER BOILER	120 V	1	300 VA	2#12+#12BND	21mmC	SPPC	
B-4	GAS HOT WATER BOILER	120 V	1	300 VA	2#12+#12BND	21mmC	SPPC	
BMS	BUILDING MANAGEMENT SYSTEM	120 V	1	200 VA	2#12+#12BND	21mmC	SPPC	
CF-1	CEILING FAN	120 V	1	360 VA	2#12+#12BND	21mmC	SPPC	
CF-2	CEILING FAN	120 V	1	360 VA	2#12+#12BND	21mmC	SPPC	
CF-3	CEILING FAN	120 V	1	360 VA	2#12+#12BND	21mmC	SPPC	
CF-4	CEILING FAN	120 V	1	360 VA	2#12+#12BND	21mmC	SPPC	
CU-1	OUTDOOR AIR CONDITIONING UNIT	208 V	2 ^	4160 VA	3#10+#12BND	21mmC	SPPC	
CU-2	OUTDOOR AIR CONDITIONING UNIT	208 V	+	3162 VA	3#12+#12BND	21mmC	SPPC	
CU-3	OUTDOOR AIR CONDITIONING UNIT	208 V		4326 VA	3#10+#12BND	21mmC	SPPC	
CWAC	CARWASH AIR COMPRESSOR	208 V	3	8637 VA	3#10+#12BND	21mmC	SPPC	
CWP-1	CARWASH EQUIPMENT PACKAGE	208 V	3	8637 VA	3#10+#12BND	21mmC	SPPC	
CWP-2	CARWASH EQUIPMENT PACKAGE	208 V	3	8637 VA	3#10+#12BND	21mmC	SPPC	
CWP-3	CARWASH EQUIPMENT PACKAGE	208 V	3	8637 VA	3#10+#12BND	21mmC	SPPC	
CWP-4	CARWASH EQUIPMENT PACKAGE	208 V	3	8637 VA	3#10+#12BND	21mmC	SPPC	
DWH-1	GAS FIRED DOMESTIC WATER HEATER	120 V	1	600 VA	2#12+#12BND	21mmC	N/A	
DWH-2	GAS FIRED DOMESTIC WATER HEATER	120 V	1	600 VA	2#12+#12BND	21mmC	N/A	
EF-1	EXHAUST FAN	208 V	3	1656 VA	3#12+#12BND	21mmC	VFD	ELECTRICAL CONTRACTOR TO PROVIDE LINE REACTOR.
EF-2	EXHAUST FAN	208 V	3	1656 VA	3#12+#12BND	21mmC	VFD	MECHANICAL TO SUPPLY VFD AND CONFIRM LOCATION. ELECTRICAL CONTRACTOR TO PROVIDE LINE REACTOR. MECHANICAL TO SUPPLY VFD AND CONFIRM LOCATION.
EF-3	EXHAUST FAN	208 V	3	1656 VA	3#12+#12BND	21mmC	VFD	ELECTRICAL CONTRACTOR TO PROVIDE LINE REACTOR. MECHANICAL TO SUPPLY VFD AND CONFIRM LOCATION.
EF-4	EXHAUST FAN	208 V	3	1656 VA	3#12+#12BND	21mmC	VFD	ELECTRICAL CONTRACTOR TO PROVIDE LINE REACTOR. MECHANICAL TO SUPPLY VFD AND CONFIRM LOCATION.
ERV-1	ENERGY RECOVERY VENTILATOR	208 V	3	2102 VA	3#12+#12BND	21mmC	SPPC	
ERV-2	ENERGY RECOVERY VENTILATOR	208 V	3	2102 VA	3#12+#12BND	21mmC	SPPC	
FF-1	FORCE FLOW HEATER	120 V	1	30 VA	2#12+#12BND	21mmC	SPPC	
FF-2	FORCE FLOW HEATER	120 V	1	30 VA	2#12+#12BND	21mmC	SPPC	
GFT-1	GLYCOL FILL TANK	120 V	1	50 VA	2#12+#12BND	21mmC	SPPC	
GFT-2	GLYCOL FILL TANK	120 V	1	50 VA	2#12+#12BND	21mmC	SPPC	
GFT-3	GLYCOL FILL TANK	120 V	1	50 VA	2#12+#12BND	21mmC	SPPC	
H-1	GAS FIRED RADIANT TUBE HEATER	120 V	1	20 VA	2#12+#12BND	21mmC	N/A	
H-2	GAS FIRED RADIANT TUBE HEATER	120 V	1	20 VA	2#12+#12BND	21mmC	N/A	
IH-3	GAS FIRED RADIANT TUBE HEATER	120 V	1	20 VA	2#12+#12BND	21mmC	N/A	
IH-4	GAS FIRED RADIANT TUBE HEATER	120 V	1	20 VA	2#12+#12BND	21mmC	N/A	
H-5	GAS FIRED RADIANT TUBE HEATER	120 V	1	20 VA	2#12+#12BND	21mmC	N/A	
H-6	GAS FIRED RADIANT TUBE HEATER	120 V	1	20 VA	2#12+#12BND	21mmC	N/A	
H-7	GAS FIRED RADIANT TUBE HEATER	120 V	1	20 VA	2#12+#12BND	21mmC	N/A	
H-8	GAS FIRED RADIANT TUBE HEATER	120 V	1	20 VA	2#12+#12BND	21mmC	N/A	
MUA-1	MAKE UP AIR UNIT	208 V	3	3743 VA	3#12+#12BND	21mmC	VFD	
MUA-2	MAKE UP AIR UNIT	208 V	3	3743 VA	3#12+#12BND	21mmC	VFD	
MUA-3	MAKE UP AIR UNIT	208 V	3	3743 VA	3#12+#12BND	21mmC	VFD	
MUA-4	MAKE UP AIR UNIT	208 V	3	3743 VA	3#12+#12BND	21mmC	VFD	
P-1	STORAGE AREA SECONDARY PUMP	120 V	1	480 VA	2#12+#12BND	21mmC	ECM	
P-2	STORAGE AREA SECONDARY PUMP	120 V	1	480 VA	2#12+#12BND	21mmC	ECM	
- -3	WASH BAY IN-SLAB HEATING CIRCULATING PU		1	197 VA	2#12+#12BND	21mmC	ECM	
P-4	WASH BAY IN-SLAB HEATING CIRCULATING PU		1	197 VA	2#12+#12BND	21mmC	ECM	
P-5	WASH BAY IN-SLAB HEATING CIRCULATING PU		1	197 VA	2#12+#12BND	21mmC	ECM	
P-6	WASH BAY IN-SLAB HEATING CIRCULATING PU		1	197 VA	2#12+#12BND	21mmC	ECM	
~~~~~~~~~~~~~~~~~~~~~~~~~~~~~~~~~~~~~~	STOBAGE AREA SECONDARY PUMP		4	480 VA~				
SF-1	SUPPLY FAN	120 V	1	370 VA	2#12+#12BND	21mmC	MG	
SF-2	SUPPLY FAN	120 V	1	217 VA	2#12+#12BND	21mmC	MG	
MP-7		120 V	·	197 VA	2#12+#12BND	21mmC		
ГР	TRAP PRIMER	120 V	1	200 VA	2#12+#12BND	21mmC	SPPC	
JH-1	HYDRONIC UNIT HEATER	120 V	1	37 VA	2#12+#12BND	21mmC	SPPC	
JH-2	HYDRONIC UNIT HEATER	120 V	1	37 VA	2#12+#12BND	21mmC	SPPC	
JH-3	HYDRONIC UNIT HEATER	120 V	1	37 VA	2#12+#12BND	21mmC	SPPC	
JH-4	HYDRONIC UNIT HEATER	120 V	1	37 VA	2#12+#12BND	21mmC	SPPC	
JH-5	HYDRONIC UNIT HEATER	120 V	1	37 VA	2#12+#12BND	21mmC	SPPC	
JH-6	HYDRONIC UNIT HEATER	120 V	1	37 VA	2#12+#12BND	21mmC	SPPC	
447	HYDRONIGUNITHEATER HYDRONIGUNITHEATER	~120V~~	4~~	37.VA~	2#12+#12BND	21mmC_	SPRG	·····
	HYDRONIC UNIT HEATER	120 V	<del>                                     </del>	62 VA	2#12+#12BND	21mmC	SPPC	

MECHANICAL EQUIPMENT SCHEDULE ABBREVIATIONS:

SPPC: SINGLE POINT POWER CONNECTION VFD: VARIABLE FREQUENCY DRIVE

MG: MAGNETIC STARTER

ECM: EC MOTOR

CONSULTANT

AECOM Canada Architects Ltd. 50 Sportsworld Crossing Road, Suite 290 Kitchener, Ontario, N2P 0A4

**PROJECT** 

### **AIRPORT RENTAL CAR QTA FACILITY**

300-100 SNOWBIRD WAY, FORT MCMURRAY, ALBERTA

PROJECT NUMBER


CLIENT

60723990



REGISTERED OWNER: FORT MCMURRAY AIRPORT AUTHORITY 300-100 SNOWBIRD WAY FORT MCMURRAY, AB, T9H 0G3

NORTH ARROW AND KEYPLAN

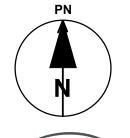

**KEY PLAN** 



**AECOM CANADA ULC** RM APEGA ID #: 64113 DATE: ______ 6 Nov. 2025 PERMIT NUMBER: P010450

NOTE:
IT IS THE RESPONSIBILITY OF THE CONTRACTORS TO INFORM
THEMSELVES OF THE EXACT LOCATION OF, AND ASSUME ALL LIABILITY
FOR DAMAGE TO ALL UTILITIES, SERVICES AND STRUCTURES WHETHER
ABOVE GROUND OR BELOW GRADE BEFORE COMMENCING THE WORK.
SUCH INFORMATION IS NOT NECESSARILY SHOWN ON THE DRAWING,
AND WHERE SHOWN, THE ACCURACY CANNOT BE GUARANTEED.
WITH THE SOLE EXCEPTION OF THE BENCHMARK(S) SPECIFICALLY
DESCRIBED FOR THIS PROJECT, NO ELEVATION INDICATED OR ASSUMED
HEREON IS TO BE USED AS A REFERENCE ELEVATION FOR ANY PURPOSE.

REGISTRATION

FOR INFORMATION ONLY NOT FOR CONSTRUCTION

ISSUE/REVISION

G	06/11/2025	ADDENDUM E01
F	24/04/2025	ISSUED FOR TENDER (DRAF
Е	14/02/2025	100% SUBMISSION
D	07/02/2025	ISSUED FOR 100% REVIEW
С	10/06/2024	60% SUBMISSION
В	31/05/2024	DRAFT 60% SUBMISSION
Α	19/04/2024	30% SUBMISSION
I/R	DATE	DESCRIPTION

PRODUCTION INFORMATION

DRAWN: Author REVIEWED: Checker

VERIFIED: Approver

SHEET TITLE **ELECTRICAL SCHEDULES** 

SHEET NUMBER

REVISION

©2023 AECOM Corporation

PROJECT NO.: 60723990

- .3 Packaging Waste Management: remove for reuse by manufacturer of pallets, crates, packaging materials and padding in accordance with Section 01 74 19- Waste Management and Disposal.
- .4 Divert unused metal materials from landfill to metal recycling facility.
- .5 Disposal and recycling of fluorescent lamps as per local regulations.
- .6 Disposal of old PCB filled ballasts.

#### Part 2 Products

### 2.1 LAMPS

.1 All light fixtures shall have an LED source.

#### 2.2 FINISHES

.1 Light fixture finish and construction to meet ULC listings and CSA certifications related to intended installation.

.....

### 2.3 OPTICAL CONTROL DEVICES

.1 As indicated in luminaire schedule.

### 2.4 LUMINAIRES

.1 Refer to luminaire schedule on electrical drawing for specification.

#### Part 3 Execution

### 3.1 INSTALLATION

- .1 Locate and install luminaires as indicated.
- .2 Provide adequate support to suit ceiling system.

### 3.2 WIRING

- .1 Connect luminaires to lighting circuits:
  - .1 Install flexible or rigid conduit for luminaires as indicated.
  - .2 All wiring, conduits and terminations in the wash bays shall be seal tight and shall be water proof.

### 3.3 LUMINAIRE SUPPORTS

.1 For suspended ceiling installations support luminaires independently of ceiling.

### 3.4 LUMINAIRE ALIGNMENT

- .1 Align luminaires mounted in continuous rows to form straight uninterrupted line.
- .2 Align luminaires mounted individually parallel or perpendicular to building grid lines.